
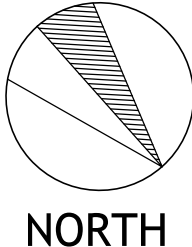


EXISTING  
**MASTER SITE DEVELOPMENT PLAN**  
 SCALE 1:100 M


6.00 METERS  
ROAD RIGHT OF WAY

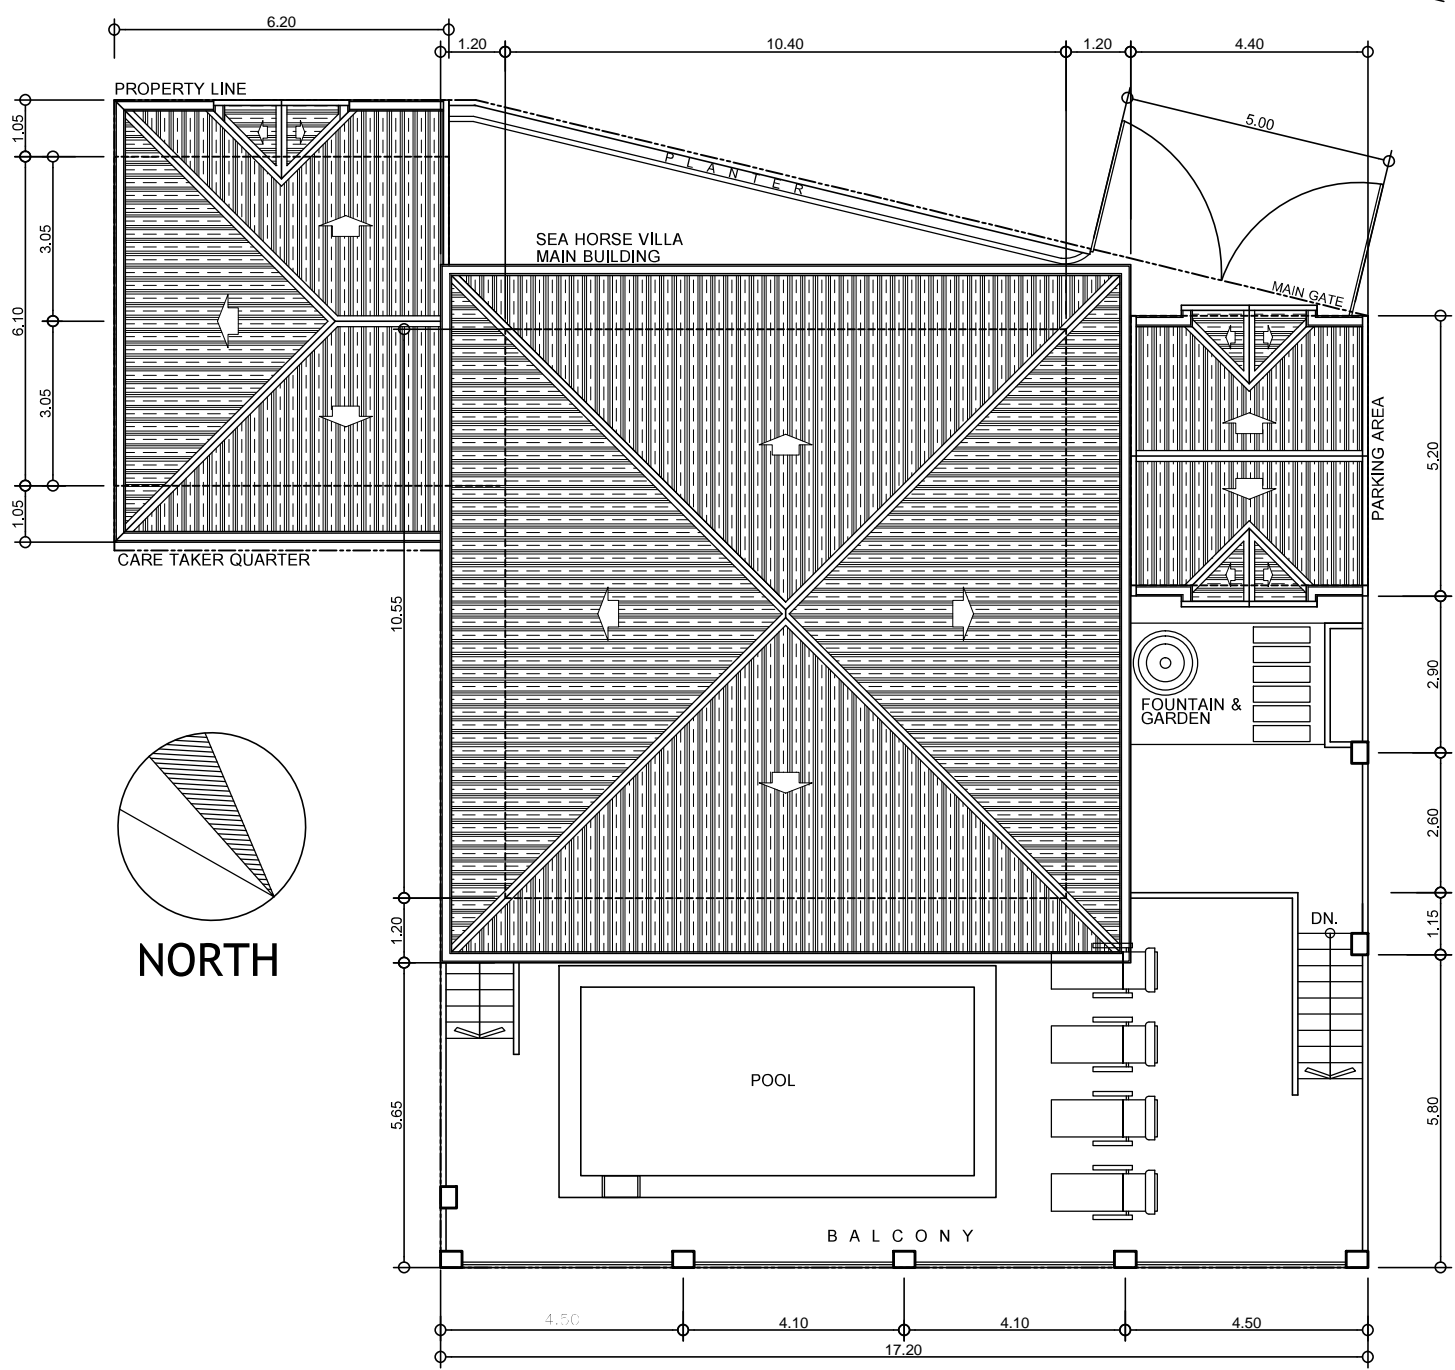

**SEAHORSE VILLA**  
 Building ; 10.0m x 10.8m = 108.0 sq.m each level  
 (5 levels x 108.0 sq.m = 540.0 sq.m + caretaker area 51.77 sq.m = 591.77 sq.m  
 + carport 30.17 sq.m)=621.40 sq.m  
 Total Building Area = 621.40 sq.m  
 Total Perimeter Fence Area = 389.80 sq.m


SEAHORSE VILLA EXISTING  
**SITE DEVELOPMENT PLAN**  
 SCALE 1:100 M

ARCHITECT:		Project	As Built Plan of 4-Storey Residential	Project Location	ST. NINO, PUERTO GALERA, ORIENTAL, MINDORO	Sheet Content	Sheet no
PRC. NO.		Owner				As shown	1
PTR NO.	DATE:						
PLACE ISSUED:	TIN		Mr. Flemming Remmer				

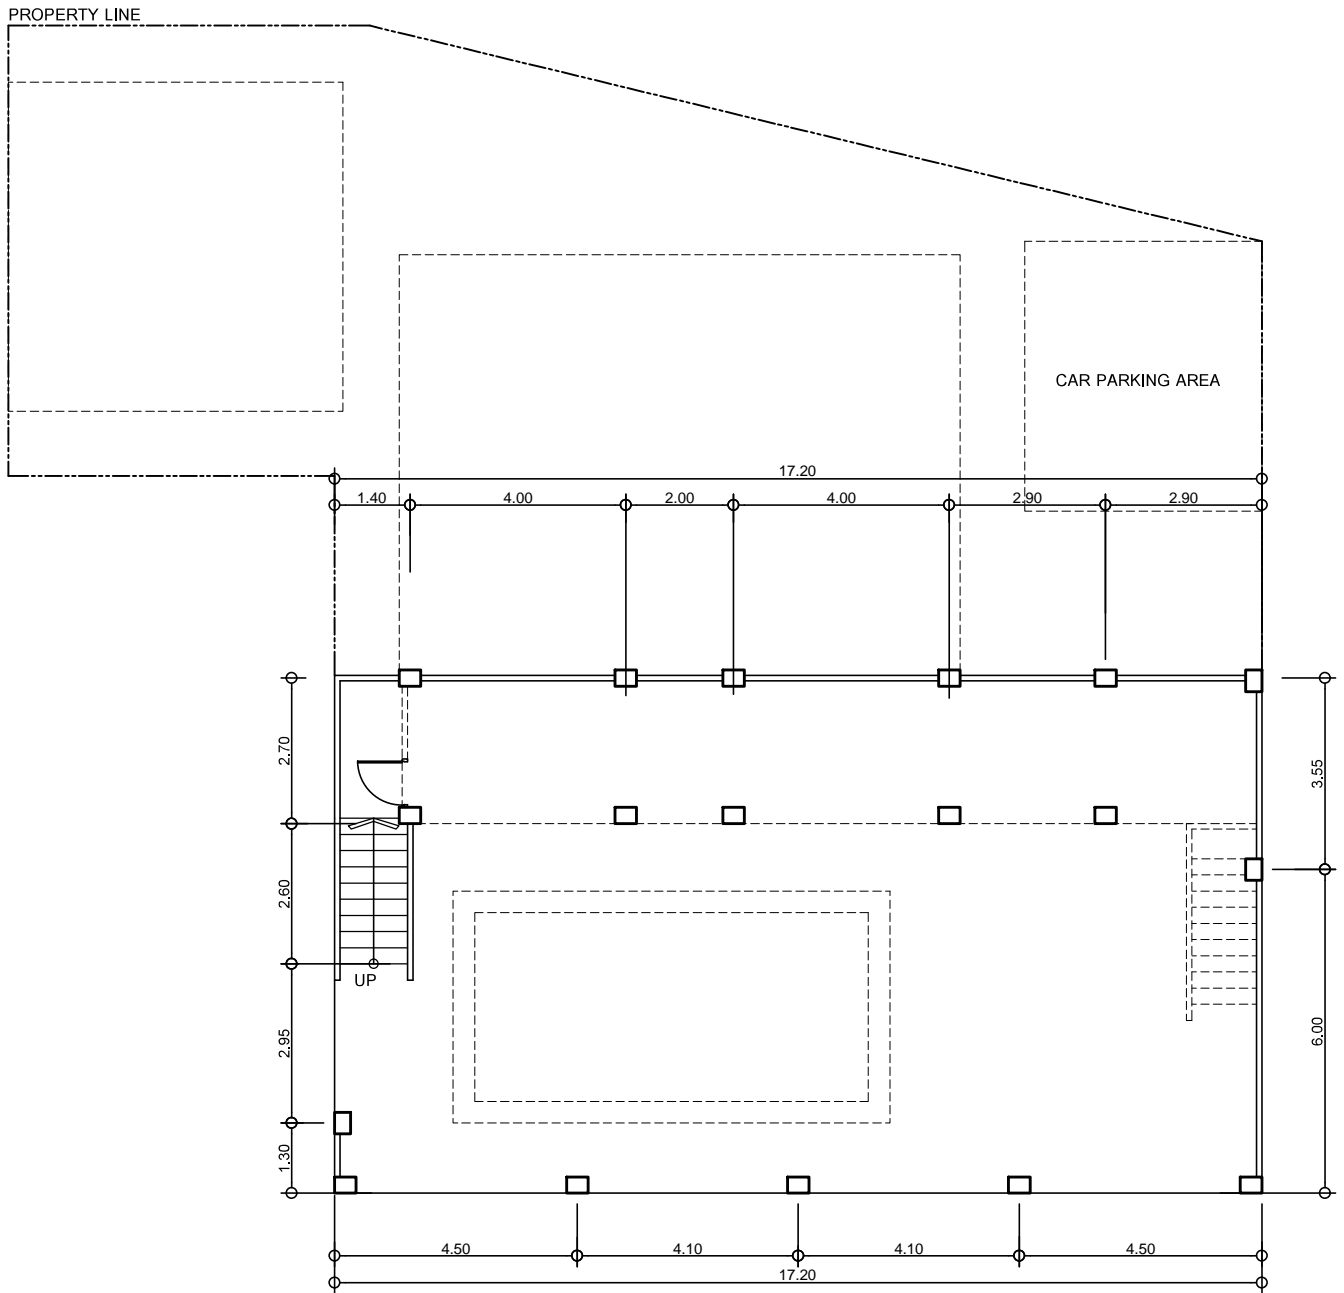


**FIRST LEVEL BASEMENT**  
 SCALE 1:100 M

ARCHITECT:		Project		Project Location	ST. NINO, PUERTO GALERA, ORIENTAL, MINDORO	Sheet Content	Sheet no
PTR NO.	DATE:	Owner				As shown	2
PLACE ISSUED:	TIN						

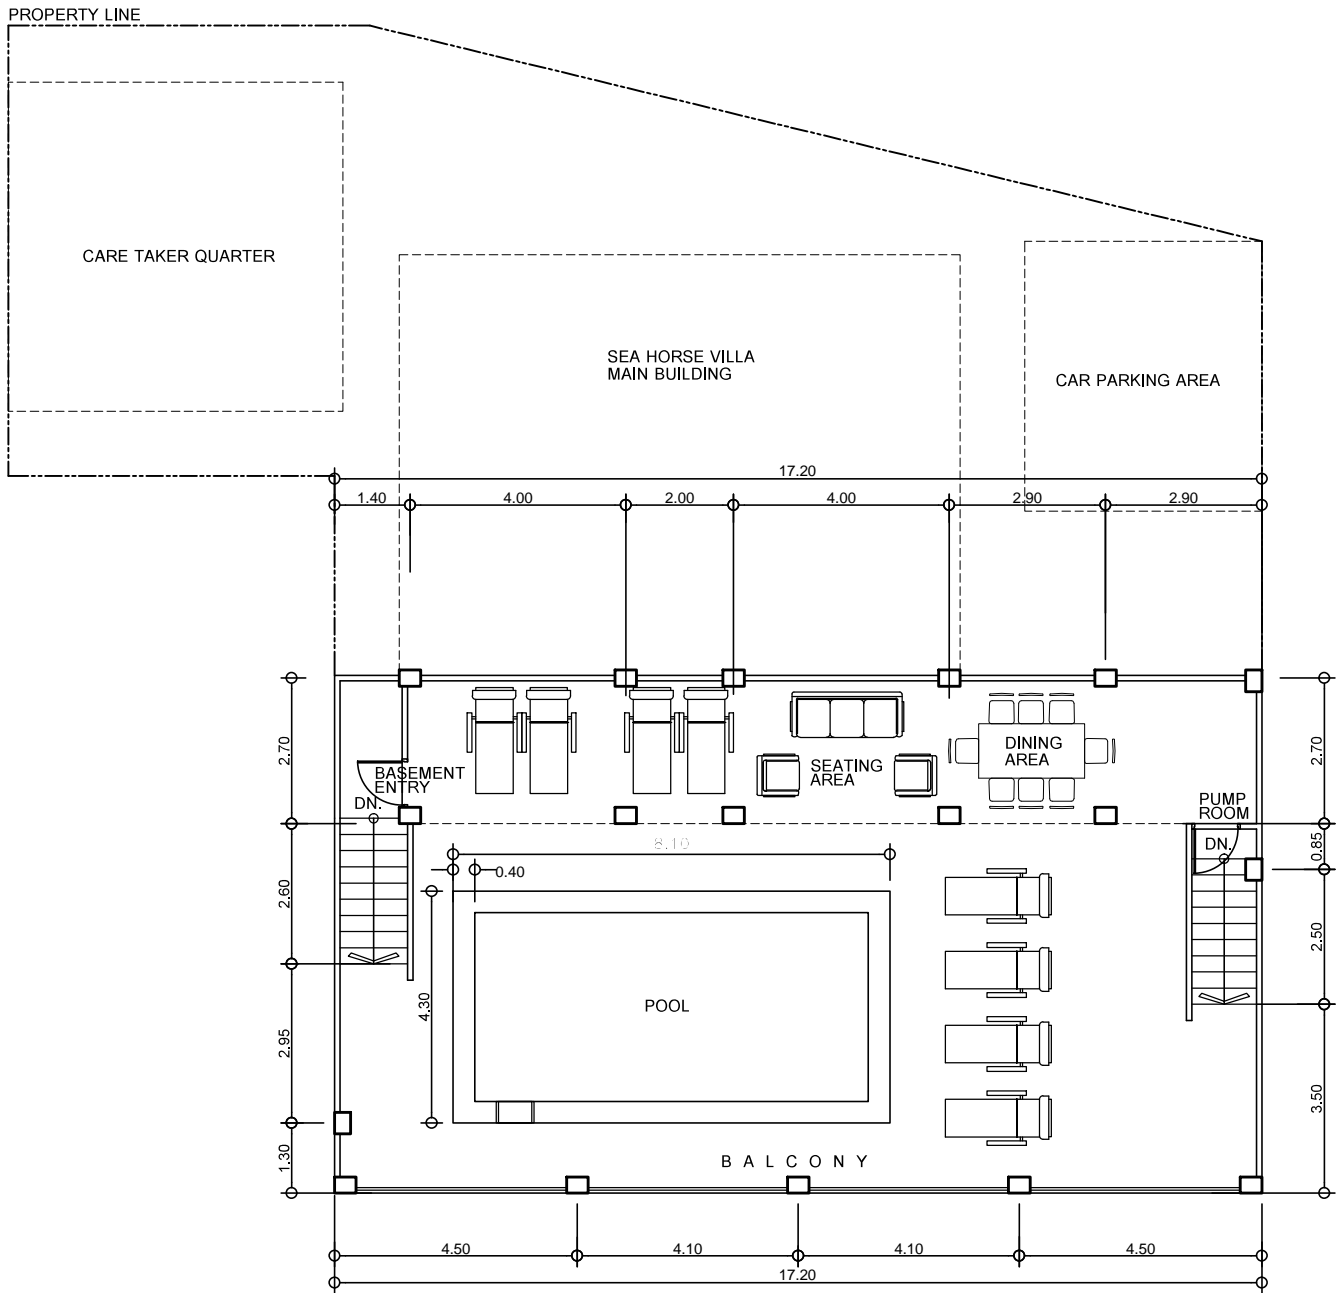



**GROUND FLOOR PLAN**  
 SCALE 1:100 M

ARCHITECT:		Project		Project Location	ST. NINO, PUERTO GALERA, ORIENTAL, MINDORO	Sheet Content	Sheet no
PTR NO.		Owner				As shown	<div style="border: 2px solid black; border-radius: 50%; width: 40px; height: 40px; display: flex; align-items: center; justify-content: center; margin: 0 auto;"> <span style="font-size: 24px; font-weight: bold;">3</span> </div>
PLACE ISSUED:	DATE:						
	TIN						

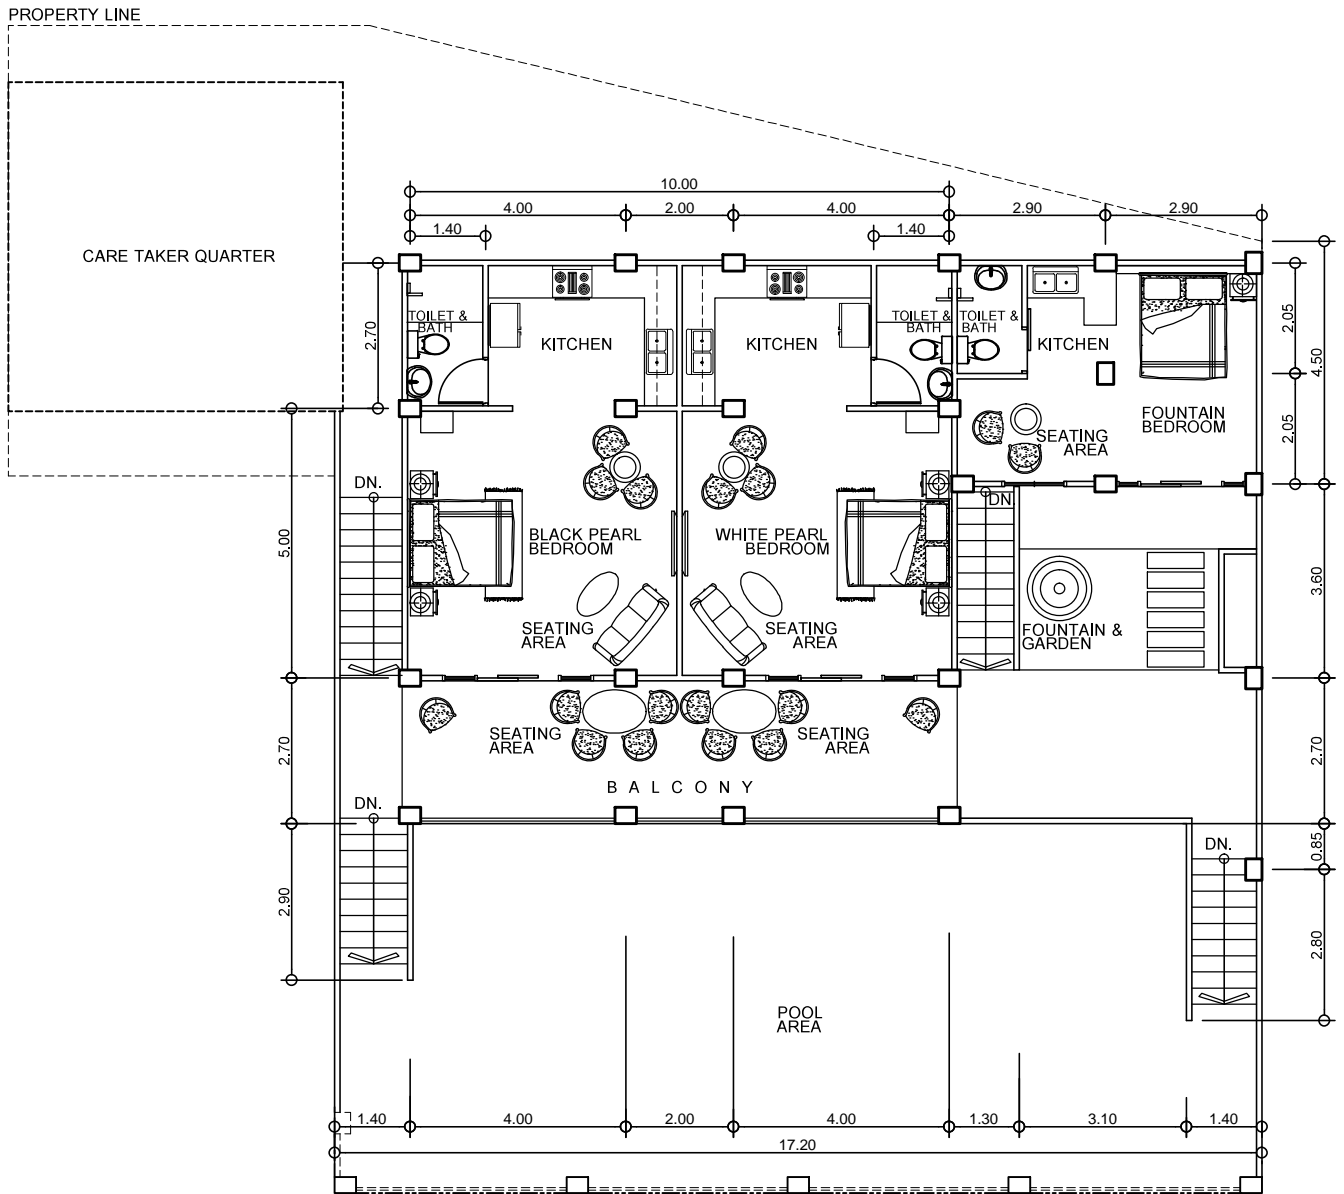


**SECOND FLOOR PLAN**  
 SCALE 1:100 M

ARCHITECT:		Project		Project Location	ST. NINO, PUERTO GALERA, ORIENTAL, MINDORO	Sheet Content	Sheet no
PTR NO.	DATE:	Owner				As shown	<div style="border: 2px solid black; border-radius: 50%; width: 40px; height: 40px; display: flex; align-items: center; justify-content: center; margin: 0 auto;"> <span style="font-size: 24px; font-weight: bold;">4</span> </div>
PLACE ISSUED:	TIN						

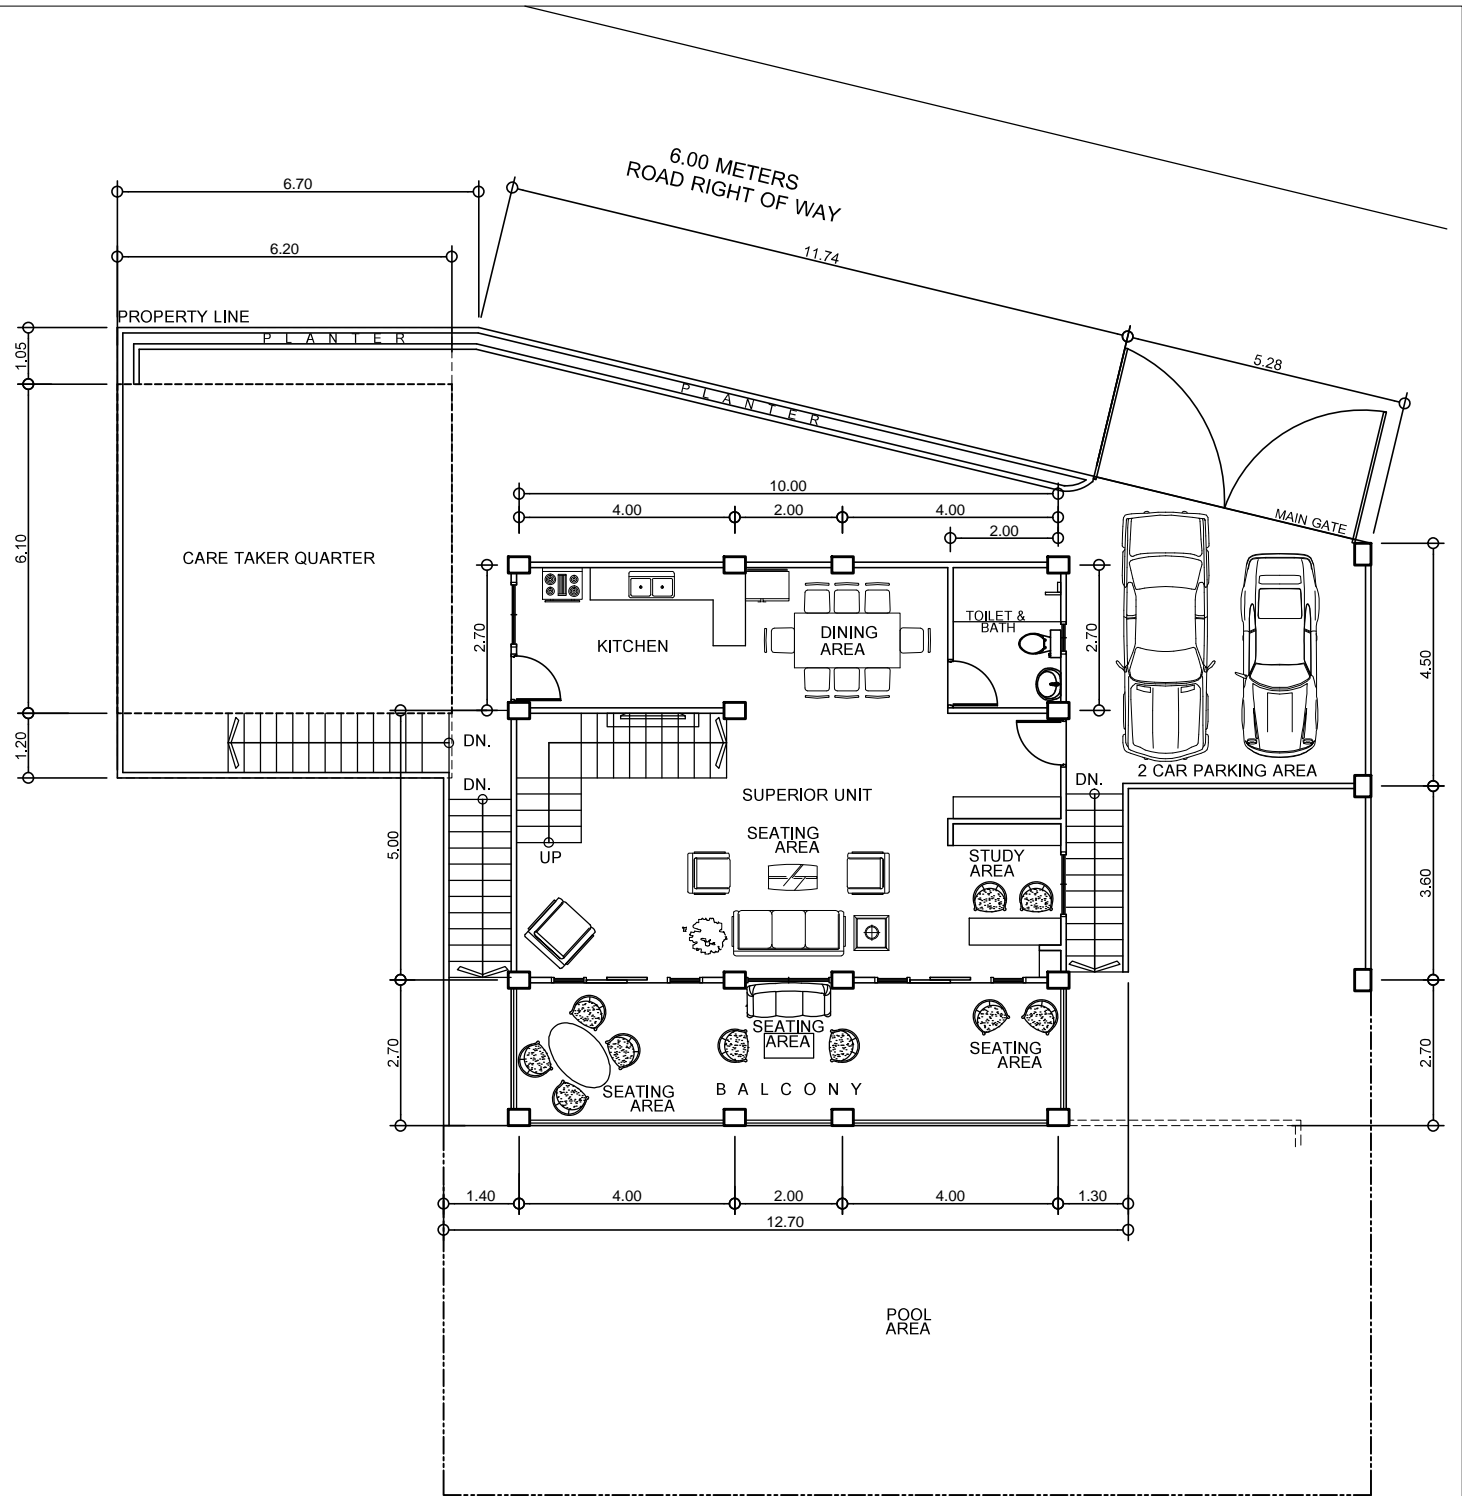



**THIRD FLOOR PLAN**  
 SCALE 1:100 M

ARCHITECT:		Project		Project Location	ST. NINO, PUERTO GALERA, ORIENTAL, MINDORO	Sheet Content	Sheet no
PRC. NO.		Owner				As shown	<div style="border: 2px solid black; border-radius: 50%; width: 40px; height: 40px; display: flex; align-items: center; justify-content: center; margin: 0 auto;"> <span style="font-size: 24px; font-weight: bold;">5</span> </div>
PTR NO.	DATE:						
PLACE ISSUED:	TIN						

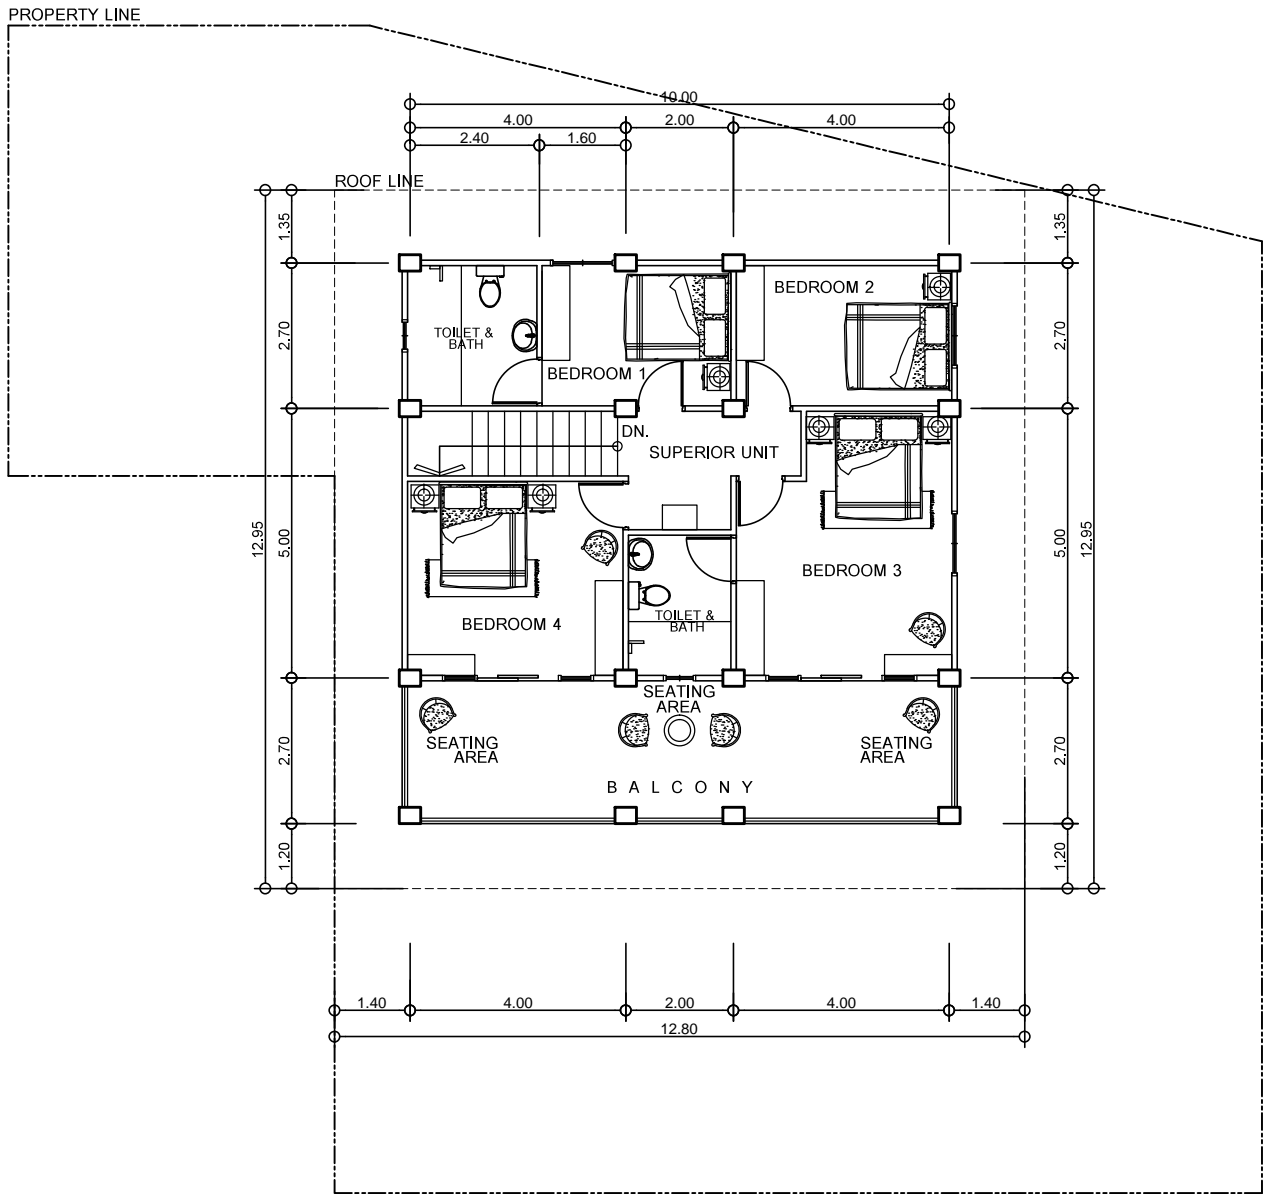



**FOURTH FLOOR PLAN**  
 SCALE 1:100 M


ARCHITECT:		Project		Project Location	ST. NINO, PUERTO GALERA, ORIENTAL, MINDORO	Sheet Content	Sheet no
PTR NO.	DATE:	Owner				As shown	<div style="border: 2px solid black; border-radius: 50%; width: 40px; height: 40px; display: flex; align-items: center; justify-content: center; margin: 0 auto;"> <span style="font-size: 24px; font-weight: bold;">6</span> </div>
PLACE ISSUED:	TIN						

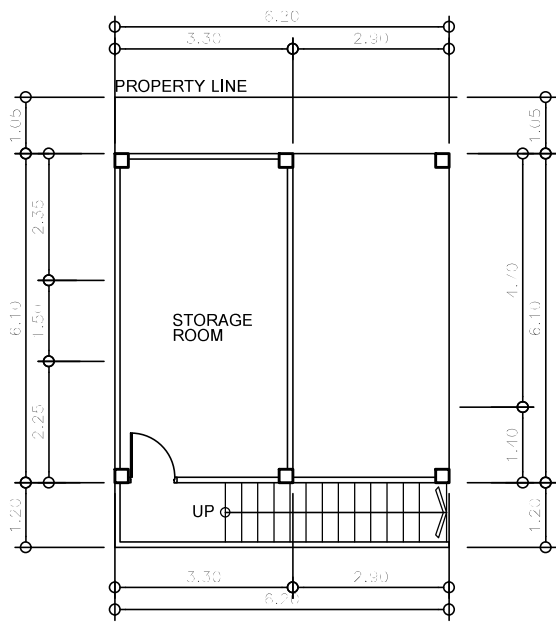

CARE TAKER QUARTER  
**GROUND FLOOR PLAN**  
 SCALE 1:100 M

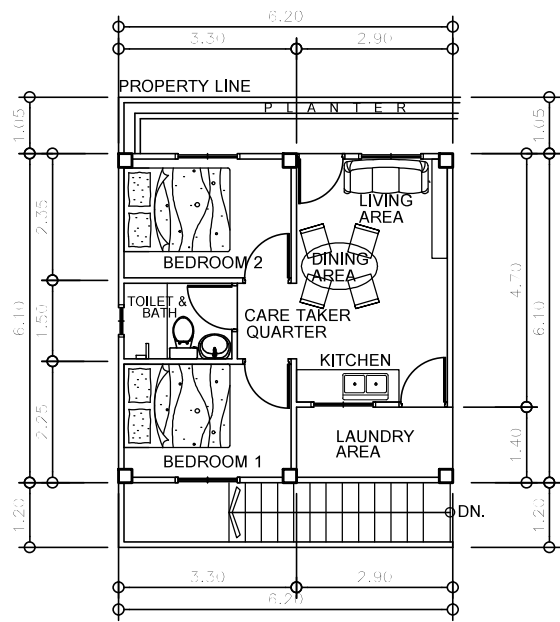

CARE TAKER QUARTER  
**SECOND FLOOR PLAN**  
 SCALE 1:100 M

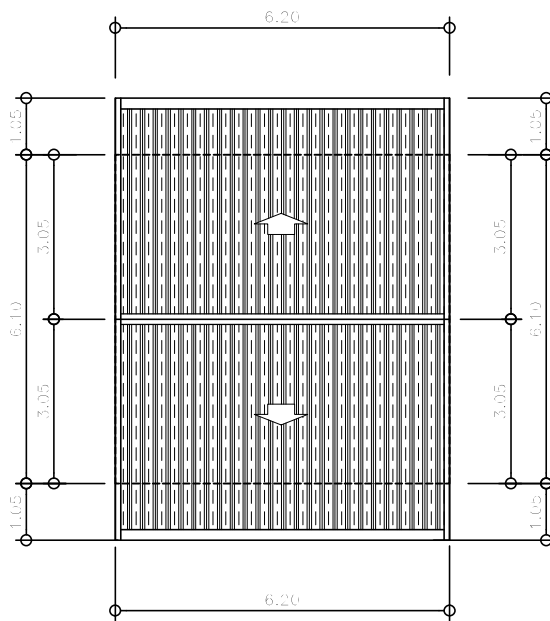

CARE TAKER QUARTER  
**ROOF PLAN**  
 SCALE 1:100 M

ARCHITECT:		Project		Project Location	ST. NINO, PUERTO GALERA, ORIENTAL, MINDORO	Sheet Content	Sheet no
PRC. NO.		Owner				As shown	7
PTR NO.	DATE:						
PLACE ISSUED:	TIN						